PROJECT ADDRESS: 1388 DAISY AVENUE, LONG BEACH, CA 90813

ACCESSOR'S PARCEL NUMBER: #7271-006-001

CONSTRUCTION TYPE: III B (ONE STORY SPRINKLERED)

BUILDING SETBACKS: FRONT - 0'

SIDE - 0'

REAR - 10'

PARKING PROVIDED: 14 SPACES

LEGAL DESCRIPTION: THE LAND REFERRED TO HEREIN BELOW IS SITUATED IN THE CITY OF LONG BEACH,

IN THE COUNTY OF LOS ANGELES, STATE OF CALIFORNIA, AND IS DESCRIBED AS FOLLOWS:

A PARCEL OF LAND IN THE CITY OF LONG BEACH, COUNTY OF LOS ANGELES, STATE OF CALIFORNIA, DESCRIBED AS FOLLOWS:
BEGINNING AT A POINT IN THE NORTH LINE OF THE SOUTH 30 FEET OF 14TH STREET, DISTANT 15.75 FEET EAST OF THE
NORTHERLY PROLONGATION OF THE CENTERLINE OF DAISY STREET, NOW DAISY AVENUE, AS SAID STREETS ARE SHOWN ON
THE MAP ON THE CHAPMAN TRACT, IN BOOK 9 PAGE 107 OF MAPS, IN THE OFFICE OF THE COUNTY RECORDER OF SAID COUNTY;
THENCE NORTH 60 FEET TO A POINT IN THE SOUTH LINE OF THE NORTH 40 FEET OF SAID 14TH STREET; THENCE EAST ALONG
SAID LINE 377.25 FEET, MORE OR LESS TO A POINT DISTANCE 250 FEET WEST FROM THE NORTH PROLONGATION OF THE WEST
LINE OF PARCEL 1 AS DESCRIBED IN DEED FROM STEPHEN TOWNSEND, ETUX, TO THE PACIFIC RAILWAY COMPANY, RECORDED IN
BOOK 1693 PAGE 60 OF DEEDS; THENCE SOUTH 60 FEET TO THE NORTH LINE OF THE SOUTH 30 FEET LESS, TO THE PLACE OF
BEGINNING, BEING PART OF THE STRIP MARKED " PACIFIC ELECTRIC RAILWAY" ON THE MAP OF THE CHAPMAN TRACT HEREINBEFORE
REFERRED TO.

EXCEPT THEREFROM THE WEST 14.25 FEET THEREOF INCLUDED WITHIN THE LINES OF DAISY AVENUE AND THE EAST 38 FEET THEREOF WITHIN THE LINE OF MAGNOLIA AVENUE.


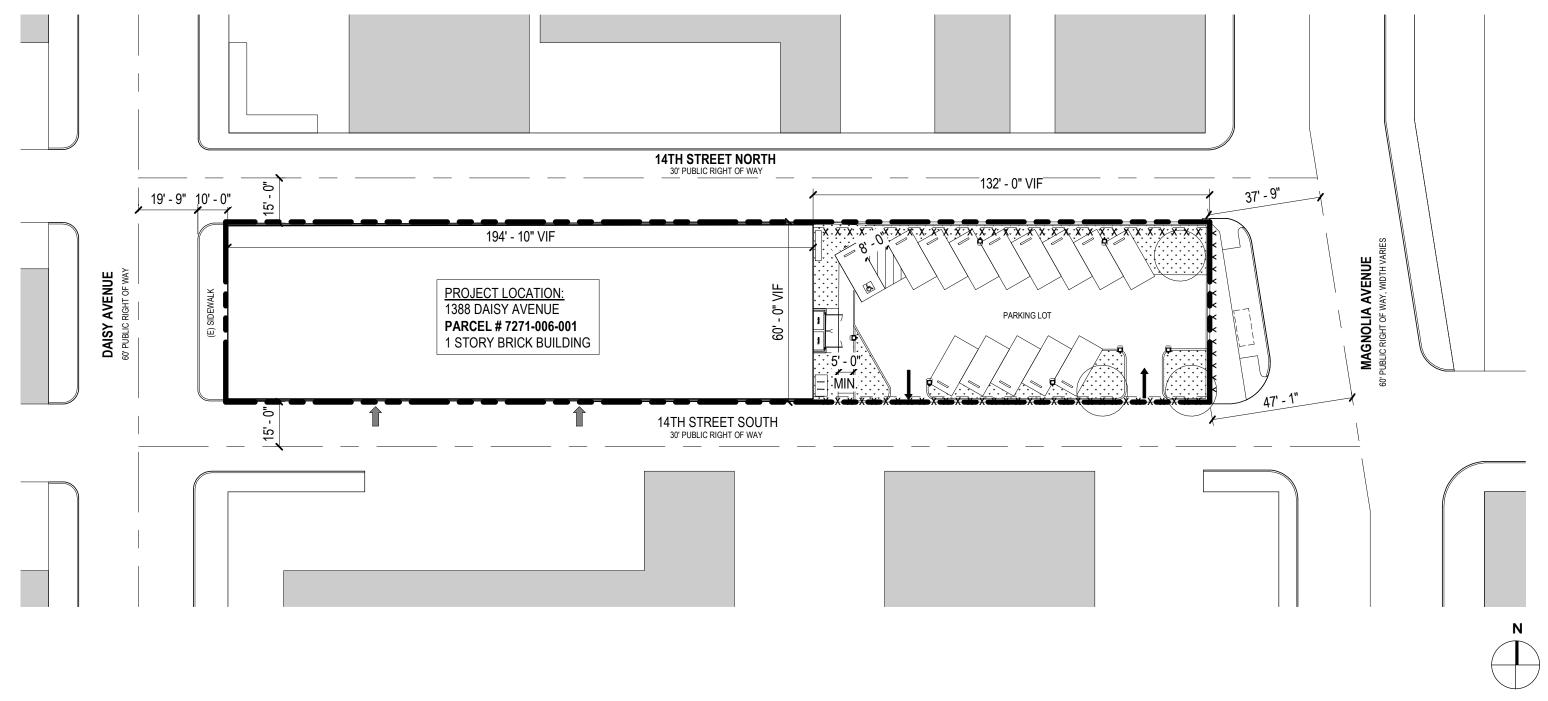


Exhibit B

100

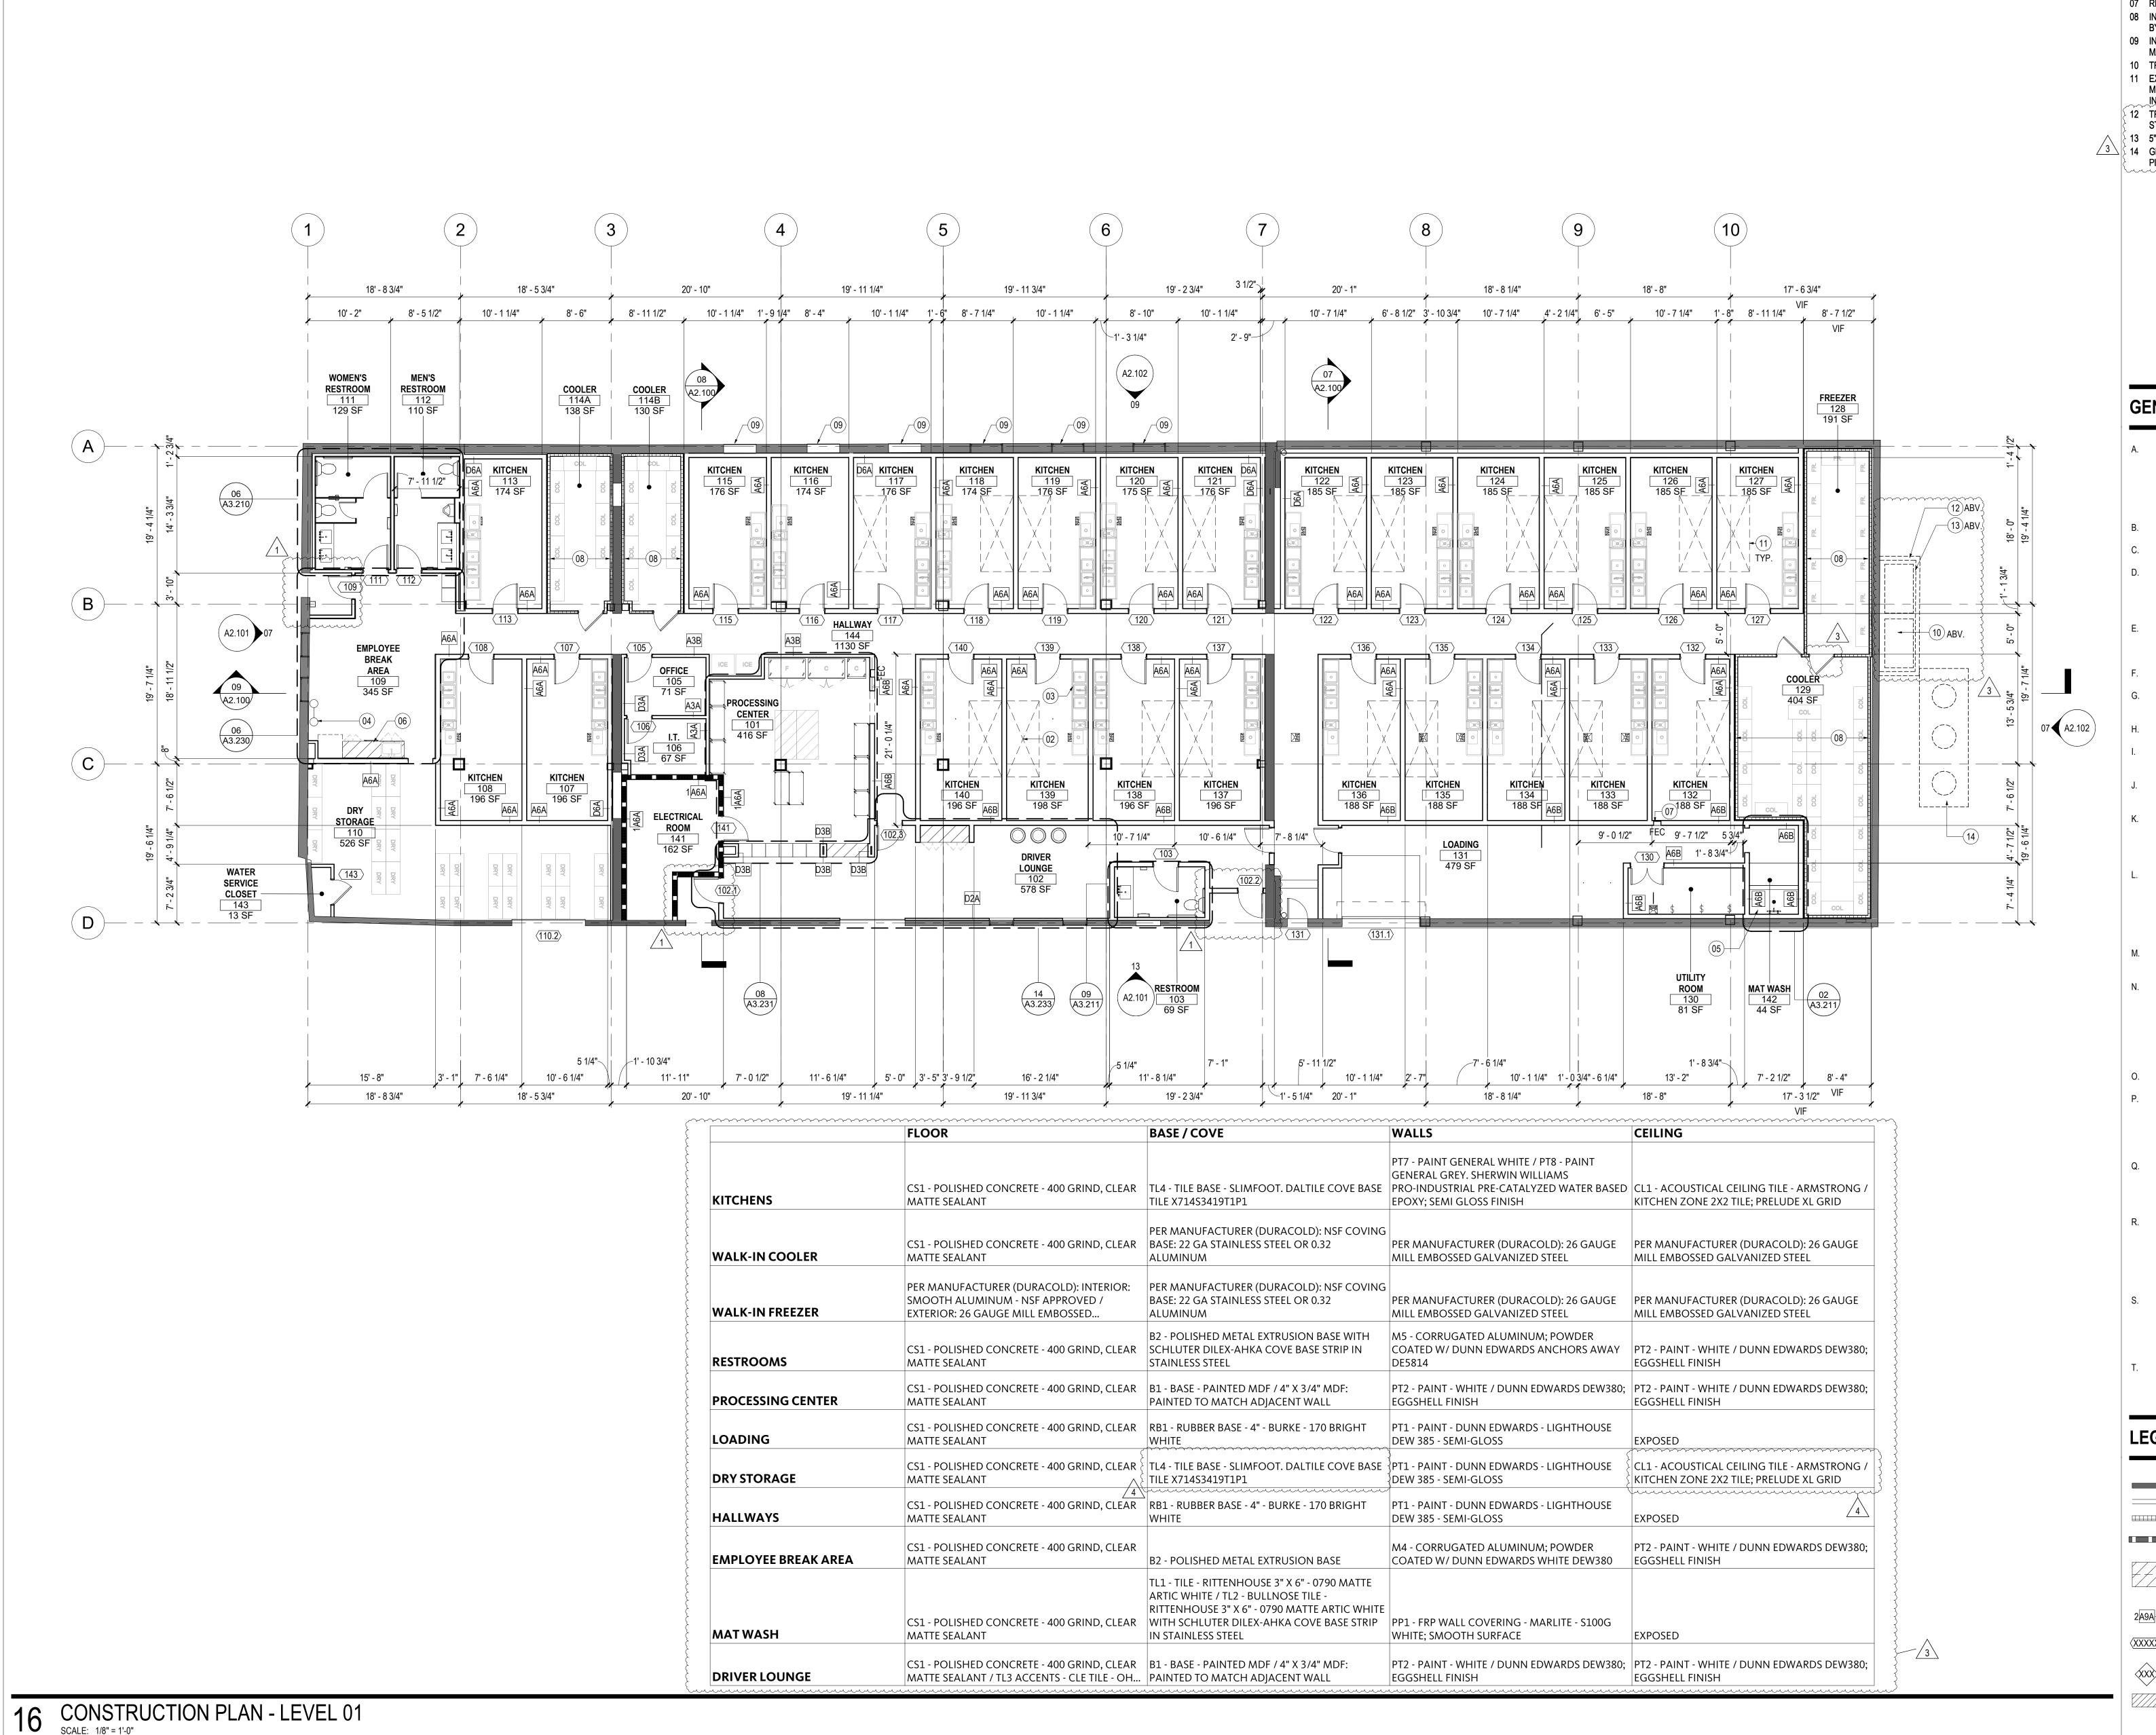

SHEET NOTES

02 KITCHEN HOOD (TYP)

RE-PAINTED

- 03 STAINLESS STEEL COUNTER W/ SINKS (TYP) 04 EXISTING FIRE RISER PIPES TO REMAIN, TO BE
- 05 MOP SINK 06 34" COUNTERTOP WITH 27" HIGH X 30" WIDE MIN.
- CLEAR SPACE BELOW SINK 07 RECESSED FIRE EXTINGUISHER CABINET
- 08 INSULATED PARTITIONS AT COOLER AND FREEZER BY MANUFACTURER
- 09 INFILL EXISTING OPENINGS WITH MASONRY TO MATCH ADJACENT WALL CONSTRUCTION
- 10 TRASH BIN 11 EXHAUST HOOD OVERHEAD; REFER TO
- MECHANICAL DRAWINGS FOR ADDITIONAL
- 12 TRASH ENCLOSURE WITH STEEL SELF-CLOSING
- STEEL GATE DOORS WITH CANE BOLTS. 13 5" CONC. SLAB ON GRADE.
- 14 GREASE INTERCEPTOR REFER TO PLUMBING PLANS.

1388 DAISY AVENUE LONG BEACH, CA 90813

Gensler 500 South Figueroa Street Tel 213.327.3600 Los Angeles, California 90071 Fax 213.327.3601

United States



∠ Date Description

02/15/19 DESIGN REVIEW

04/17/19 ISSUE FOR PERMIT/BID

05/29/19 PLAN CHECK CORRECTIONS

3 06/10/19 PLAN CHECK CORRECTIONS REVISIONS

4 06/19/19 HEALTH / MECHANICAL CORRECTIONS

324 sunset avenue suite e venice, ca 90291 310 450 8100 fax 310 450 8144

GENERAL NOTES

- A. ALL PARTITIONS ARE DIMENSIONED FROM FINISH FACE TO FINISH FACE, UNO ALL DIMENSIONS MARKED 'CLEAR' OR 'HOLD' SHALL BE MAINTAINED AND SHALL ALLOW FOR THICKNESS OF ALL FINISHES INCLUDING CARPET, STONE, TILE, FABRIC PANELS,
- MILLWORK, ETC. PROVIDE LVL 4 FINISH AT ALL GYP BD
- SURFACES, UNO USE 5/8" TYPE 'X' GYP BD. THROUGHOUT
- PROVIDE EXTRA STUDS AS REQUIRED TO MOUNT ELECTRICAL OR MECHANICAL CONTROLS. ENSURE STUDS REMAIN PLUMB. CRIMP OR SCREW ATTACH TO RUNNERS AS
- NOTIFY ARCHITECT IN WRITING OF CONFLICTS, DIMENSIONAL OR OTHER DISCREPANCIES PRIOR TO PROCEEDING
- WITH WORK OR AREAS AFFECTED. ALL GLASS TO BE TEMPERED. ALL EXPOSED EDGES SHALL BE POLISHED. DOOR JAMB LOCATIONS SHALL BE TYP 4"
- FROM ADJ. WALL UNO. MAINTAIN DOOR CLEARANCES AS REQUIRED NEW INTERIOR DOORS/FRAMES SHALL BE FACTORY FINISHED UNO UNDERCUT OF DOORS TO CLEAR TOP OF

OTHERWISE NOTED.

ALL INTERIOR GLAZING TO BE SAFETY GLAZING IN ACCORDANCE WITH APPLICABLE PATCH AND REPAIR SURFACES DAMAGED AS A RESULT OF WORK PERFORMED ON THIS

PROJECT. PATCH & REPAIR EXISTING

FLOOR FINISHES BY 1/4" UNLESS

SURFACES AS REQ'D TO RECEIVE NEW PATCH AND REPAIR ALL EXISTING WALLS COLUMNS, FLOORS AND SURFACES SCHEDULED TO REMAIN AS REQUIRED TO LEAVE THEM SMOOTH AND EVEN TO RECIEVE NEW SCHEDULED FINISHES. REFER

TO FINISH PLAN FOR ADDITIONAL

- INFORMATION. NEW GWB CONSTRUCTION ADJOINING EXISTING CONSTRUCTION IN PLANE SHALL BE FLUSH WITH NO VISIBLE JOINTS, UNO GC TO COORDINATE INSTALLATION OF ALL CABINETS AND DEVICES AS INDICATED ON DWGS TO ENSURE PROPER WALL RECESS IS PROVIDED. ALL DEVICES INSTALLED IN EXISTING FIRE RATED PARTITIONS SHALL
- RECEIVE FIRE RATED J-BOX. GC TO MAINTAIN INTEGRITY OF EXISTING FIRE RATINGS WHERE OCCURS. PROVIDE SHEET METAL BLOCKING FOR ALL MILLWORK AND FURNITURE OVERHEADS. DO NOT SCALE DRAWINGS. WRITTEN DIMENSIONS GOVERN. ALL PARTITION
- LOCATIONS, DIMENSIONS AND TYPES, ALL DOOR AND WINDOW LOCATIONS SHALL BE AS SHOWN ON CONSTRUCTION PLAN. IN CASE OF CONFLICT NOTIFY ARCHITECT. GC TO SURVEY FIELD CONDITIONS AND VERIFY THAT WORK IS FEASIBLE AS SHOWN. VERIFY LOCATIONS OF FLOOR OUTLETS AND OTHER OUTLETS IN RELATION TO
- STRUCTURAL AND OTHER ELEMENTS. GC SHALL MARK LOCATIONS OF PARTITIONS AND DOORS ON FLOOR WITH CHALK FOR REVIEW BY ARCHITECT PRIOR TO INSTALLATION. REVIEW SHALL BE FOR DESIGN INTENT. CONTRACTOR TO VERIFY ALL CONDITIONS IN ORDER TO ENSURE PROPER FIT.
- FACILITY MUST HAVE SIGNAGE IN THE RESTROOMS INDICATING THAT EMPLOYEES MUST WASH THEIR HANDS BEFORE RETURNING TO WORK; SIGNAGE INDICATING THAT SMOKING IS PROHIBITED ON PREMISES IS REQUIRED THROUGHOUT. PROVIDE CODE REQUIRED ACCESSIBLE
- RESTROOM SIGNAGE FOR BOTH DOOR MOUNTED AND WALL-MOUNTED SIGNAGE.

LEGEND

EXISTING CONSTRUCTION TO REMAIN NEW PARTITION

INSULATED COOLER/ FREEZER WALL 1 HR. RATED PARTITION

MILLWORK ABOVE

WALL TYPE REFERENCE DOOR REFERENCE NUMBER (REFER TO DOOR SCHEDULE)

N.I.C. (NOT IN CONTRACT)

WINDOW REFERENCE NUMBER (REFER TO WINDOW SCHEDULE)

A1.201

DAISY AVENUE, LONG

CONSTRUCTION PLAN - LEVEL 01

SCALE: 1/8" = 1'-0"

© 2019 Gensler

Seal / Signature

Project Number

Description

Scale

1/8" = 1'-0"

05.2276.000



